

KINGDOM OF THAILAND
MINISTRY OF TRANSPORT
STATE RAILWAY OF THAILAND

DESIGN CONSULTANTS



CONTRACTOR




SUVAKABHONG AIRPORT RAIL LINK
AND CITY AIR TERMINAL
PLATFORM LEVEL PLAN (ZONE D)
SHEET 4 OF 9



AS-BUILT DRAWING

DATE:	2019/05/20
BY:	AS/HA-ARC/ALR-01-004
CHECKED BY:	S. SAKUNT
APPROVED BY:	S. SAKUNT
DATE:	2019/05/20

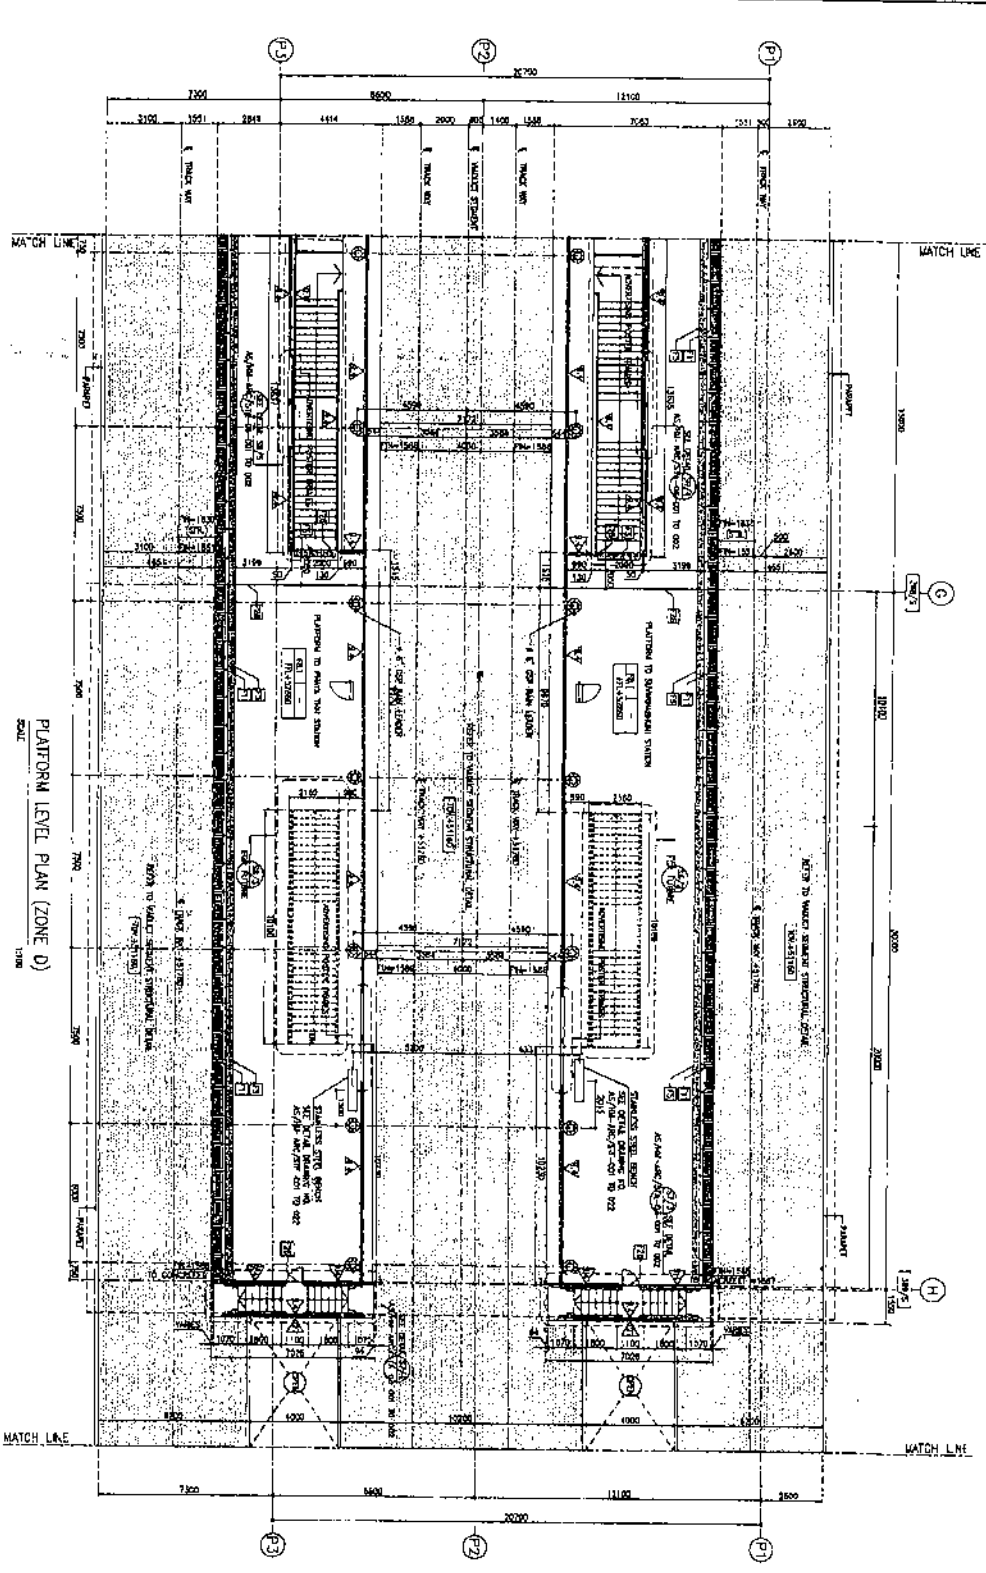

PLATFORM LEVEL PLAN (ZONE D)
SCALE: 1:100



NO.	DATE	REVISION	APPROVED	PREPARED BY	SCALE
1	2019/05/20	AS-BUILT DRAWING	S. SAKUNT	S. SAKUNT	1:100

